

NORTH CENTRAL DISTRICT HEALTH DEPARTMENT

Computer File #: 05-3893
Permit #: 0-05-51

SITE EVALUATION
 SEWAGE PERMIT

NEW SYSTEM
 REPLACEMENT

Fee Paid: \$ 350.00 CR
Receipt #: 25
Jurisdiction: 25

EHS #: 6003160031
Date: 1-31-05 3-4-05

Travel Time: 5:30 AM - 5:30 PM
Insp. Time: 5:30 AM - 5:30 PM

Name: Riverdance Lodge - Cabins 3+4	Mailing address: P.O. Box 579
Phone:	City: Coeur d'Alene State ID Zip 83816
1/4 Sec.: Section: 32 Township: 33N Range: LE	Address/location of property: Syringa - Riverdance
Lot: Block: Subdivision:	
Parcel # (from Tax Assessor's Office):	Lot size: Water supply: <input checked="" type="checkbox"/> Public <input type="checkbox"/> Private <input checked="" type="checkbox"/> Well <input type="checkbox"/> Spring

Type of Dwelling	<input checked="" type="checkbox"/> Gravelless Drainfield	<input type="checkbox"/> Absorption Bed	<input type="checkbox"/> Pit/Vault Privy	<input type="checkbox"/> In trench SF
() Single Family <input type="checkbox"/> Multiple Family # Bedrooms:	<input type="checkbox"/> Gravel Drainfield	<input type="checkbox"/> Steep Slope Drainfield	<input type="checkbox"/> Sand Mound	<input type="checkbox"/> Recirculating SF
() Commercial <input checked="" type="checkbox"/> Other 2 Cabins	<input type="checkbox"/> Capping Fill	<input type="checkbox"/> 2 Cell Lagoon	<input type="checkbox"/> Intermittent SF	Other

Tank Size: 2-1000-Tanks	Slope: 5	Critical Setbacks: 6	ft. Nearest Well: 50	ft.
Distance From Septic Tank to: Dwelling Foundation:	ft.	Disposal Area: 600	ft. Distance to Surface Water: 200	ft.
Disposal Area: Effective Area Required: 600	sq. ft. Dimensions: L. 200 W. 3 D. 3	ft.		
Property Lines: Front: 5 ft. Back: 5 ft. Side: 5 ft.	Dwelling Foundation: 10 ft.	ft. Nearest Well: 100 ft.		

No. 1 Test Hole: 0-72 32	No. 2 Test Hole:	No. 3 Test Hole:

Size of absorption system based on Soil Type:

Site Evaluation: Approved Approved with Conditions Disapproved EHS Initials D.E.K. Date 1-31-05

REMARKS: 40 % REDUCTION IN SQUARE FEET OF DRAINFIELD IF DOMED GRAVELLESS CHAMBER MATERIAL IS USED.

The information provided on this application is accurate to the best of my knowledge. I understand that any false statements may result in disapproval of this permit. The subsurface sewage disposal installation must be constructed by the home/landowner or a sewer installer. Section 1-3006.01 - 1-3007.01.

Owner _____ I hereby authorize the health authority to have access to this property for the purpose of performing the
Contractor _____ requested services and I certify that all the above information is accurate.
Other _____
Applicant Signature: Jah E King Date: 3-4-05

Permit Issued By: Jah E King Date: 3-4-05

Renewal Date: / /

FINAL INSPECTION

Tank Size: 2-1,000 gallon	gallons	Type of Tank: Concrete	Depth to Riser/Tank: 18"
Distance from Septic Tank to: Dwelling Foundation: 8 ft 10	ft.	Disposal Area: 8 ft 22'	ft. Nearest Well: 100 ft
Disposal Area: Effective Area: 600	sq. ft. Dimensions: L. 120 W. 3 D. 3	ft.	Distance from Disp. Area to Surface Water: 200 ft.
Property Lines: Front: 5 ft. Back: 5 ft. Side: 5 ft.	Dwelling Foundation: 10 ft 18 ft	ft.	Nearest Well: 100 ft
<input checked="" type="checkbox"/> Approved <input type="checkbox"/> Disapproved Date: 4-29-05	Inspected By: <u>Jah E King</u>	Installer & #: Cole McPherson	

REMARKS: Domed Chamber system - Serves 2 Cabins

T-33N
R-6 E-62
Sec 32
Cont

IDAHO COUNTY ENERGIZING AUTHORIZATION

Name: Eric D. Lodge Phone: _____

Address: _____

has been issued Individual Sewer Permit No.: 0-05-51

by the North Central District Health Dept. (NCDHD) for the construction
of Colon

at (location) Colon Sec. 32 Twp. 33N Rge. 6E
The requirements of Idaho County Ordinance #32 having been
complied with, the above-described structure may now be energized by

the Idaho County Power Company.


(Sig.) D. E. Lodge NCDHD Official. Date 2-14-85

Date of Energizing: _____

(Sig.) _____ Power Company Official
PRINTCRAFT

Name: River dense Lodge (Cabins 3+4) Date: 1-31-05 Permit # 0-0551

Proposed Site Plan

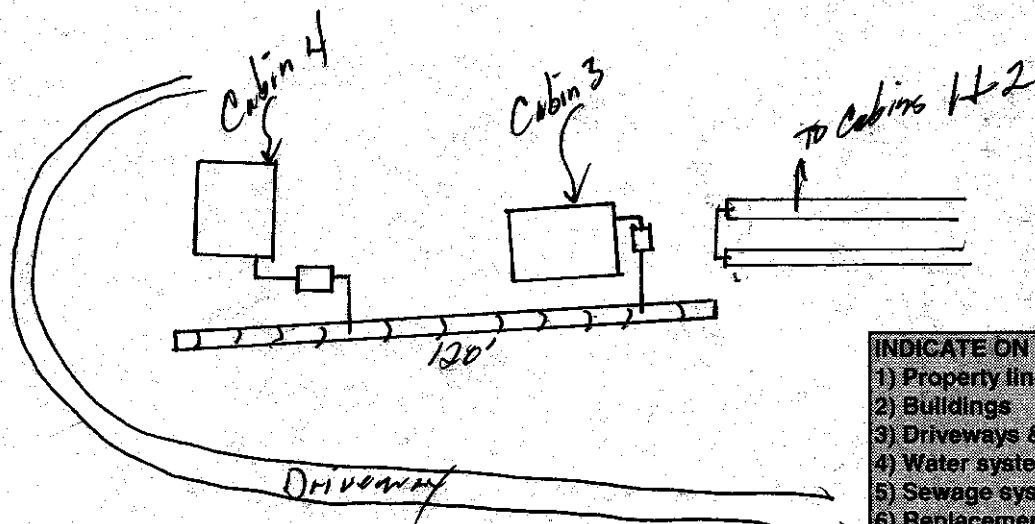

INDICATE ON SKETCH

- 1) Property lines
- 2) Buildings
- 3) Driveways & patios
- 4) Water system, pipes
- 5) Sewage system
- 6) Replacement area
- 7) Streams within 300
- 8) Slope of lot
- 9) Adjacent roads
- 10) Other drainfields

As-Built

