

# NORTH CENTRAL DISTRICT HEALTH DEPARTMENT

Computer File # 95-3894

Permit # Q-05-52

SITE EVALUATION  
 SEWAGE PERMIT

NEW SYSTEM  
 REPLACEMENT

Fee Paid: \$ 350.00 CR  
Receipt #: 3006315  
Jurisdiction: 25

EHS #: 6003 1 6003 1 6003  
Date: 1-31-05 3-4-05 1 4-29-05

Travel Time: 1 1/2 hr  
Insp. Time: 1 1/2 hr

Name: River dance Lodge - Cabin #5

Phone:

1/4 Sec.: 32 Section: 32 Township: 33N Range: 6E

Lot: Block: Subdivision: Cabin # 5

Parcel # (from Tax Assessor's Office):

Lot size:

Mailing address: P.O. Box 579

City: Cooper's Bluff State: Id Zip: 83816

Address/location of property: Syringe - Riverdance

Type of Dwelling	<input checked="" type="checkbox"/> Gravelless Drainfield	<input type="checkbox"/> Absorption Bed	<input type="checkbox"/> Pit/Vault Privy	<input type="checkbox"/> Intrench SF
( ) Single Family ( ) Multiple Family # Bedrooms:	( ) Gravel Drainfield	( ) Steep Slope Drainfield	( ) Sand Mound	( ) Recirculating SF
( ) Commercial ( ) Other <u>Cabin - 1 Room</u> <u>Handicap Acc</u>	( ) Capping Fill	( ) 2 Cell Lagoon	( ) Intermittent SF	Other

Tank Size: 1000 gallons Slope:

Critical Setbacks:

Distance From Septic Tank to: Dwelling Foundation: 5 ft. Disposal Area: 6 ft. Nearest Well: 50 ft.

Disposal Area: Effective Area Required: 300 sq. ft. Dimensions: L. 100 W. 3 D. 3 ft. Distance to Surface Water: 200 ft.

Property Lines: Front: 5 ft. Back: 5 ft. Side: 5 ft. Dwelling Foundation: 10 ft. Nearest Well: 100 ft.

No. 1 Test Hole	No. 2 Test Hole	No. 3 Test Hole
<u>D-72</u>	<u>B2</u>	

Size of absorption system based on Soil Type: B2

Site Evaluation:  Approved ( ) Approved with Conditions ( ) Disapproved

EHS Initials D.E.K.

Date 1-31-05

REMARKS: 40 % REDUCTION IN SQUARE FEET OF DRAINFIELD IF DOMED GRAVELLESS CHAMBER MATERIAL IS USED.

The information provided on this application is accurate to the best of my knowledge. I understand that any false statements may result in disapproval of this permit. The subsurface sewage disposal installation must be constructed by the homeowner or a sewer installer, Section 1-3006.01 - 1-3007.01.

Owner \_\_\_\_\_

I hereby authorize the health authority to have access to this property for the purpose of performing the requested services and I certify that all the above information is accurate.

Contractor \_\_\_\_\_

Other \_\_\_\_\_

Applicant Signature: Dal E King

Date: 3-4-05

Permit Issued By: Dal E King

Date: 3-4-05

Renewal Date: \_\_\_\_\_

RENEWAL FORM				
--------------	--	--	--	--

## FINAL INSPECTION

Tank Size: <u>1000</u> gallons	Type of Tank: <u>Concrete</u>	Depth to Riser/Tank: <u>18</u>
Distance from Septic Tank to: Dwelling Foundation: <u>75</u> ft.	Disposal Area: <u>15</u> ft.	Nearest Well: <u>100+</u> ft.
Disposal Area: Effective Area: <u>300</u> sq. ft. Dimensions: L. <u>60</u> W. <u>3</u> D. <u>3</u> ft.	Distance from Disp. Area to Surface Water: <u>200</u> ft.	
Property Lines: Front: <u>5+</u> ft. Back: <u>5+</u> ft. Side: <u>5+</u> ft.	Dwelling Foundation: <u>25</u> ft.	Nearest Well: <u>100+</u> ft.
( <input checked="" type="checkbox"/> Approved) Disapproved Date: <u>4-29-05</u>	Inspected By: <u>Dal E King</u>	Installer & #: <u>Colin McPherson</u>

REMARKS: Domed Chamber system

T-33N R-1 E per. 32

b. cap

### IDAHO COUNTY ENERGIZING AUTHORIZATION

Name: River Dance Lodge Phone: \_\_\_\_\_

Address: \_\_\_\_\_

has been issued Individual Sewer Permit No.: 0-05-52

by the North Central District Health Dept. (NCDHD) for the construction  
of Cabin #5

at (location) Syrinx Sec. 32 Twp. 33N Rge. 6E  
The requirements of Idaho County Ordinance #32 having been  
complied with, the above-described structure may now be energized by

the Idaho County Power Company.

(Sig.) C. E. Ely NCDHD Official. Date 7-24-05

Date of Energizing: \_\_\_\_\_

(Sig.) \_\_\_\_\_ Power Company Official


PRINTCRAFT

Name: Rivardance Lodge

Date: 1-31-05

Permit # D-05-52

### Proposed Site Plan

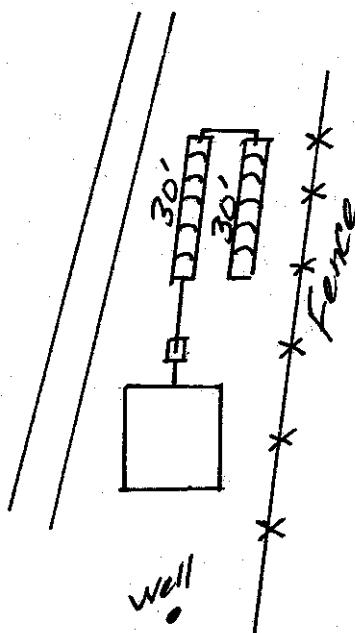

**INDICATE ON SKETCH**

- 1) Property lines
- 2) Buildings
- 3) Driveways & patios
- 4) Water system, pipes
- 5) Sewage system
- 6) Replacement area
- 7) Streams within 300'
- 8) Slope of lot
- 9) Adjacent roads
- 10) Other drainfields

### As-Built

